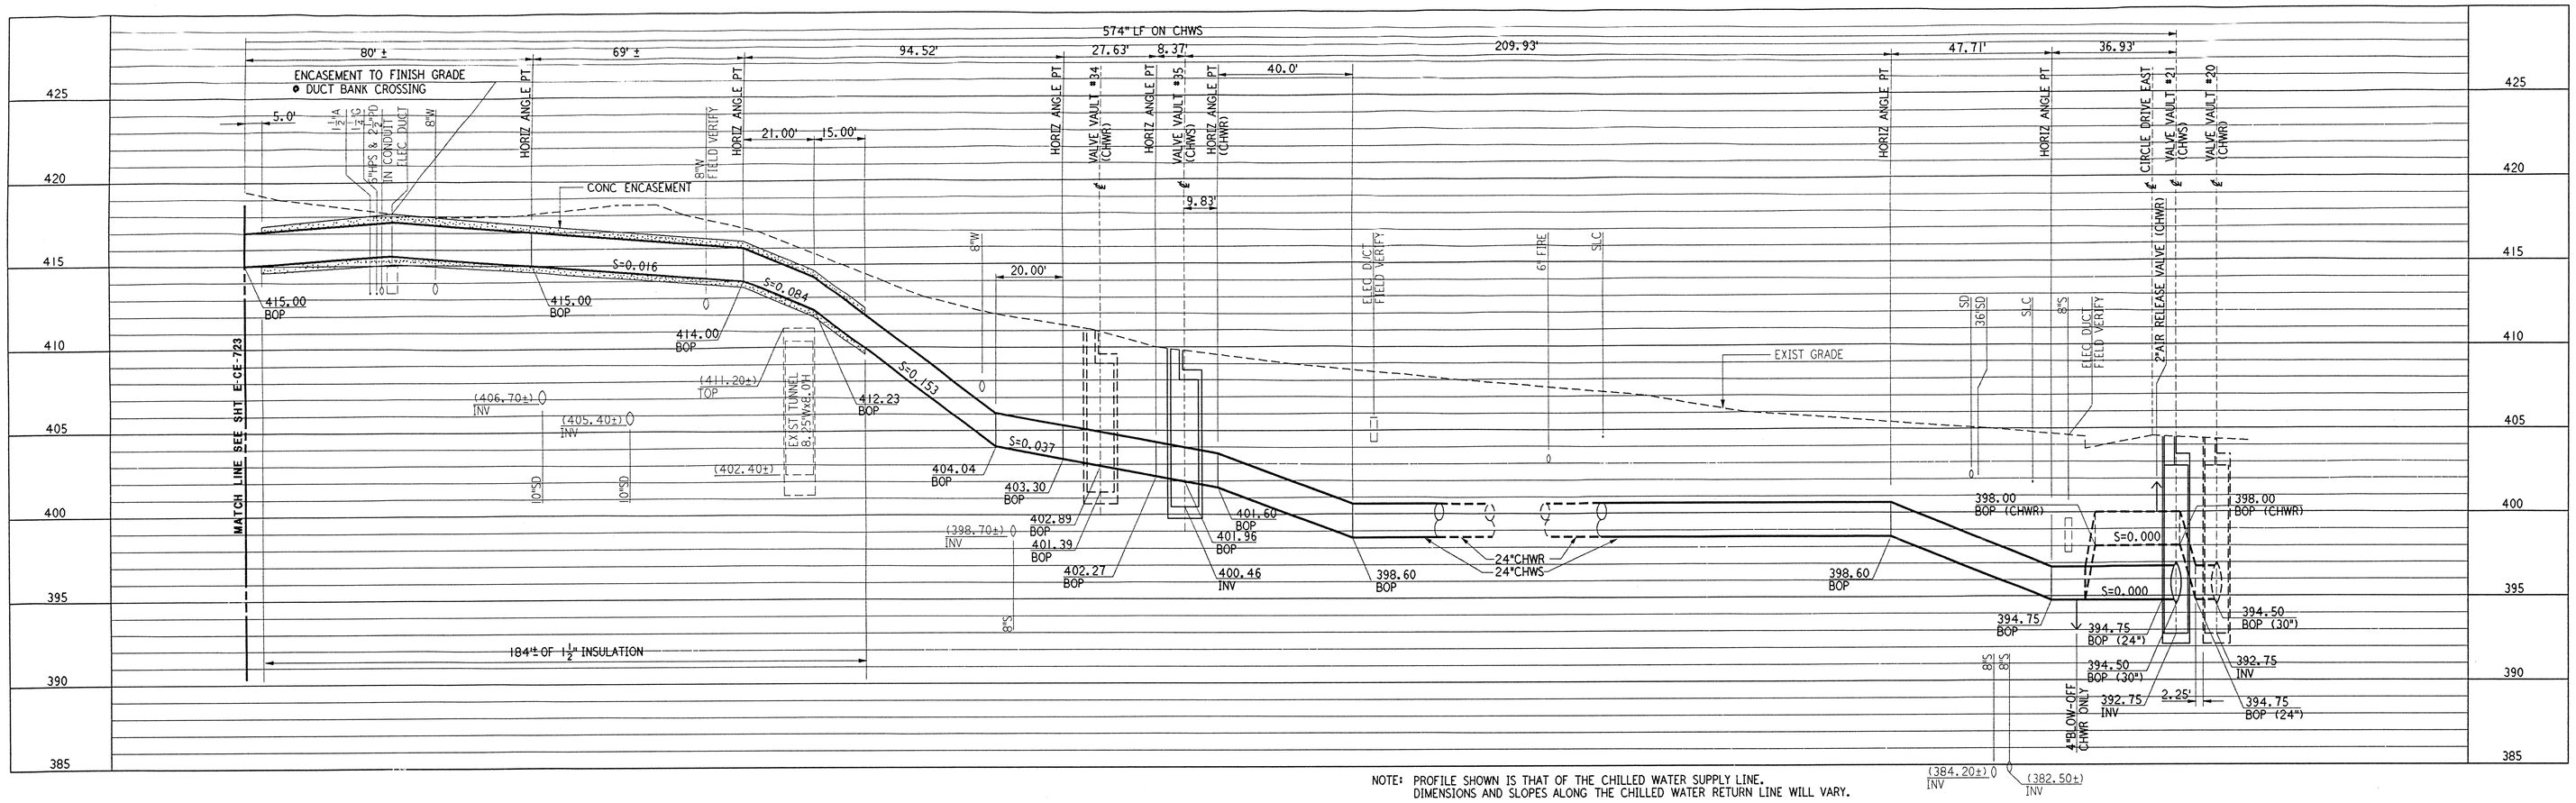

NOTE: PROFILE SHOWN IS THAT OF THE CHILLED WATER SUPPLY LINE. DIMENSIONS AND SLOPES ALONG THE CHILLED WATER RETURN LINE WILL VARY.

PROFILE

SCALE: HORIZ 1"=20'
VERT 1"=4'

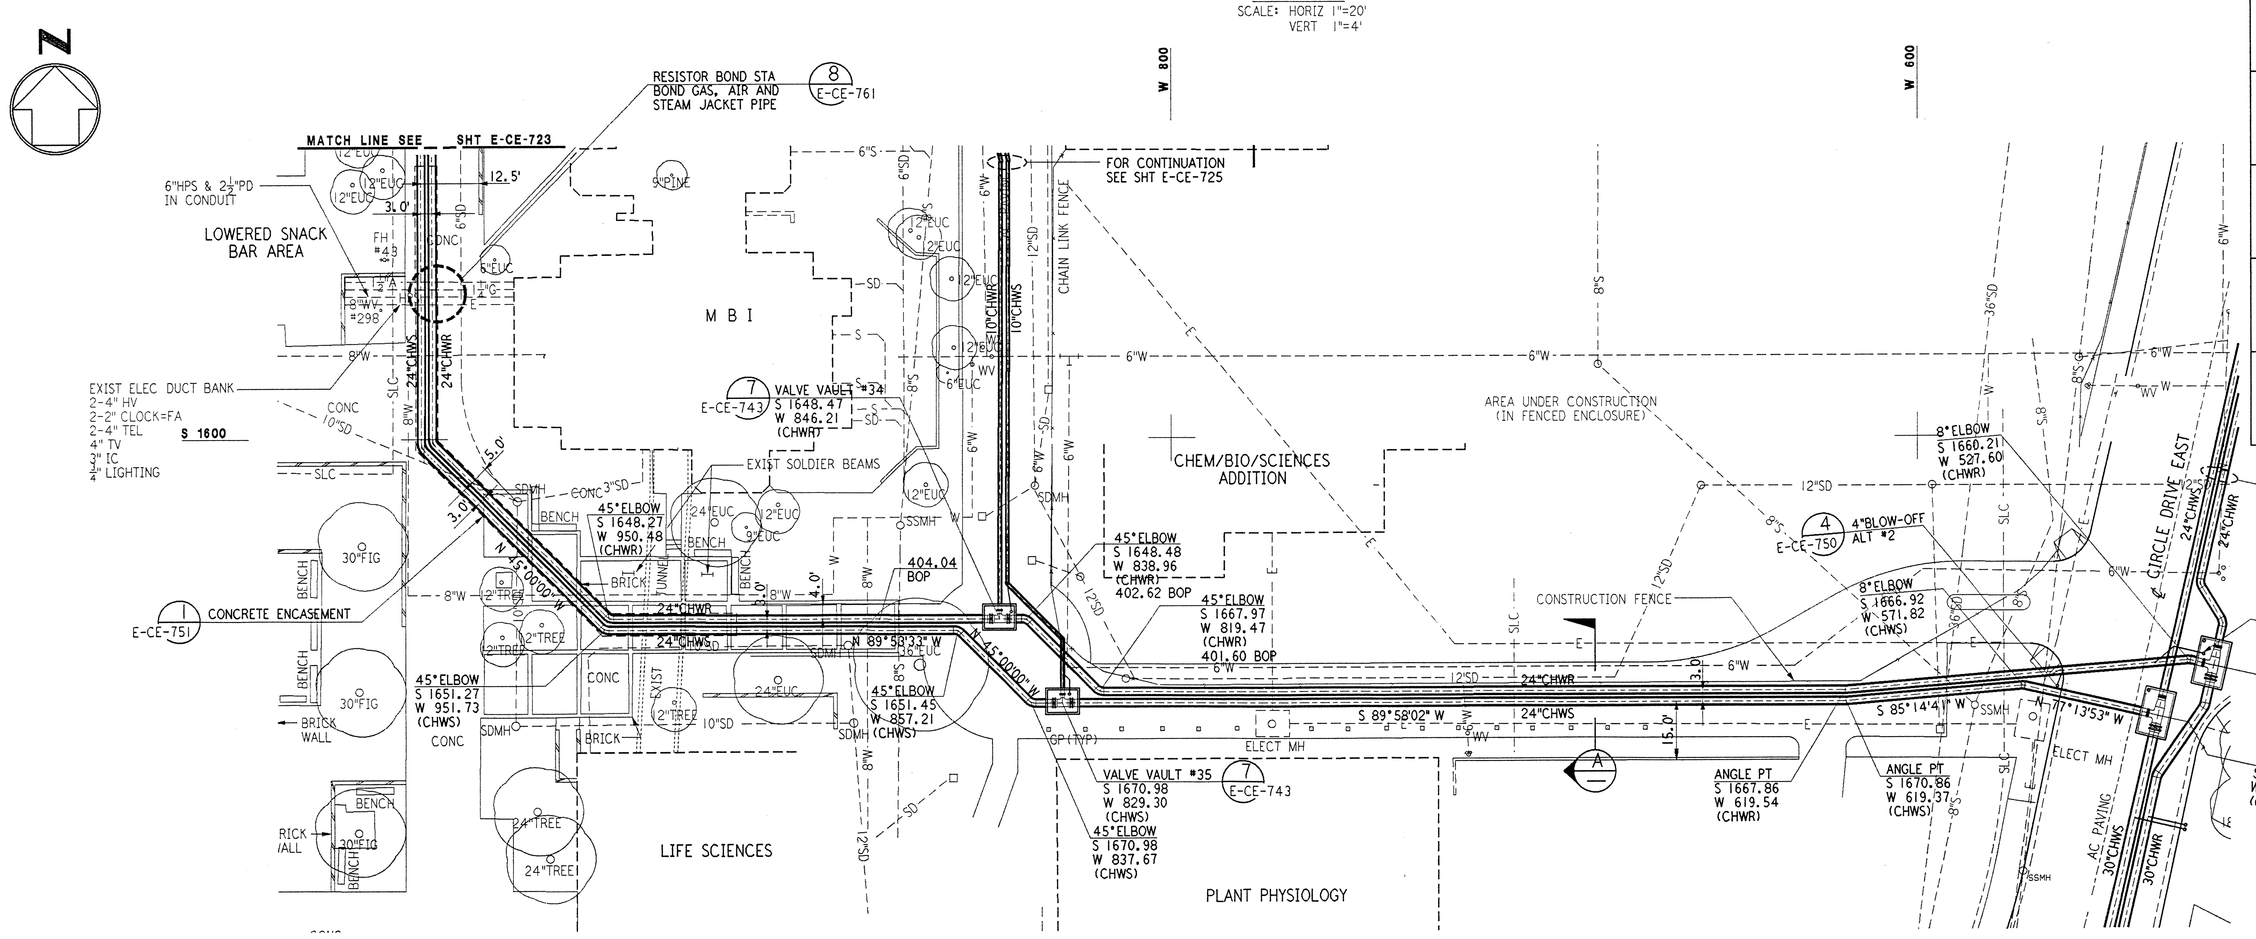

PLAN

SCALE: HORIZ 1"=20'

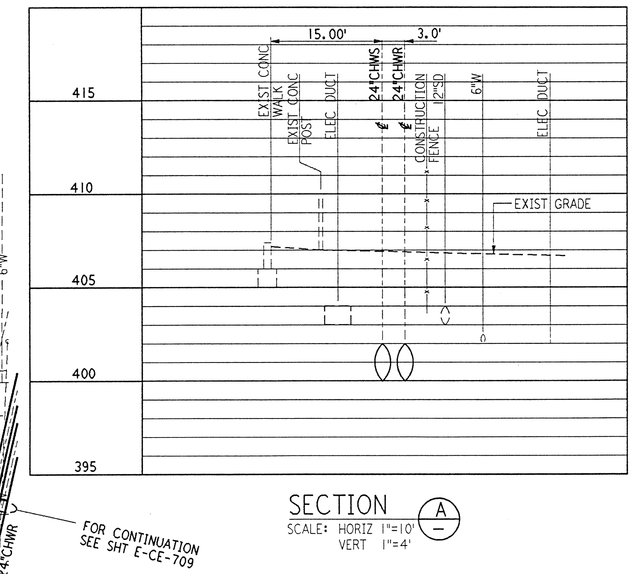

SECTION

SCALE: HORIZ 1"=10'
VERT 1"=4'

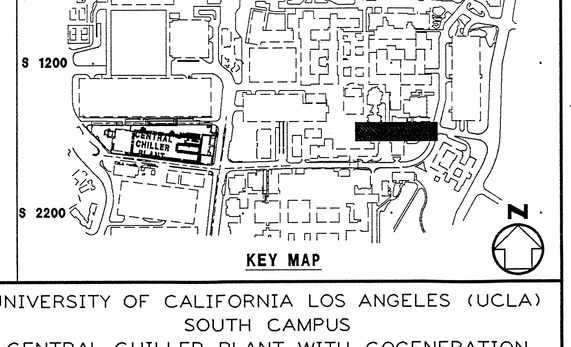

KEY MAP

4' 0 4' 8'
1" = 4'

20' 0 20' 40'
1" = 20'

REFERENCES DRAWING NO.	DESCRIPTION	REFERENCES DRAWING NO.	DESCRIPTION

REVISIONS NO.	DATE	BY	CHKD	SEC	PE/EM	PROJ DIR	DESCRIPTION

REVISIONS NO.	DATE	BY	CHKD	SEC	PE/EM	PROJ DIR	DESCRIPTION
1	9/16/92	MC	[illegible]	—	[illegible]	VLB	AS BUILT / INCORPORATED DCN #1.2

FOR CONSTRUCTION		DATE
DRAWN	CT	05/27/92
CHECKED	VGN	05/27/92
APVD SECT HD/EM	—	—
APVD PROJ ENG	LW	05/27/92
APVD PROJ DIR	VLB/LW	05/27/92

MAIN 1893
CHAS. T. MAIN, INC.
WESTERN OPERATIONS - POWER DIVISION
PASADENA, CALIFORNIA

UNIVERSITY OF CALIFORNIA LOS ANGELES (UCLA)
SOUTH CAMPUS
CENTRAL CHILLER PLANT WITH COGENERATION
(UCLA PROJECT NO. 944600)

TITLE	SCALE	ACCOUNT NUMBER	JOB NUMBER	REVISIONS
SOUTH CAMPUS PRIMARY CHILLED WATER DISTRIBUTION PLAN & PROFILE	AS NOTED	7529	4336	1
	DOCUMENT NUMBER	E-CE-724		

ENG-GE-24 (12/79)

This document and the design it covers are the property of CHAS. T. MAIN, INC. and are provided for the sole use of the intended recipient in connection with the project. Any other use, reproduction, copying, disclosure or distribution is prohibited without the express written consent of CHAS. T. MAIN, INC.
They are merely loaned and on the borrower's express agreement that they will not be reproduced, copied, lent or disclosed directly or indirectly to any other person or firm, nor used for any purpose other than that for which they are specifically loaned or furnished to the borrower.

EFN 98 | EAS FILE CORR. IRVINE, CA | 0037 A | E-CE-724 | SCANNED PRIMARY CHILLED WATER DISTRIBUTION PLAN & PROFILE CENTRAL CHILLER PLANT # 944600